



**GENERAL NOTES**  
1. REFER TO DWG. S-0 FOR GENERAL NOTES AND SPECIFICATIONS.


**AS BUILT**

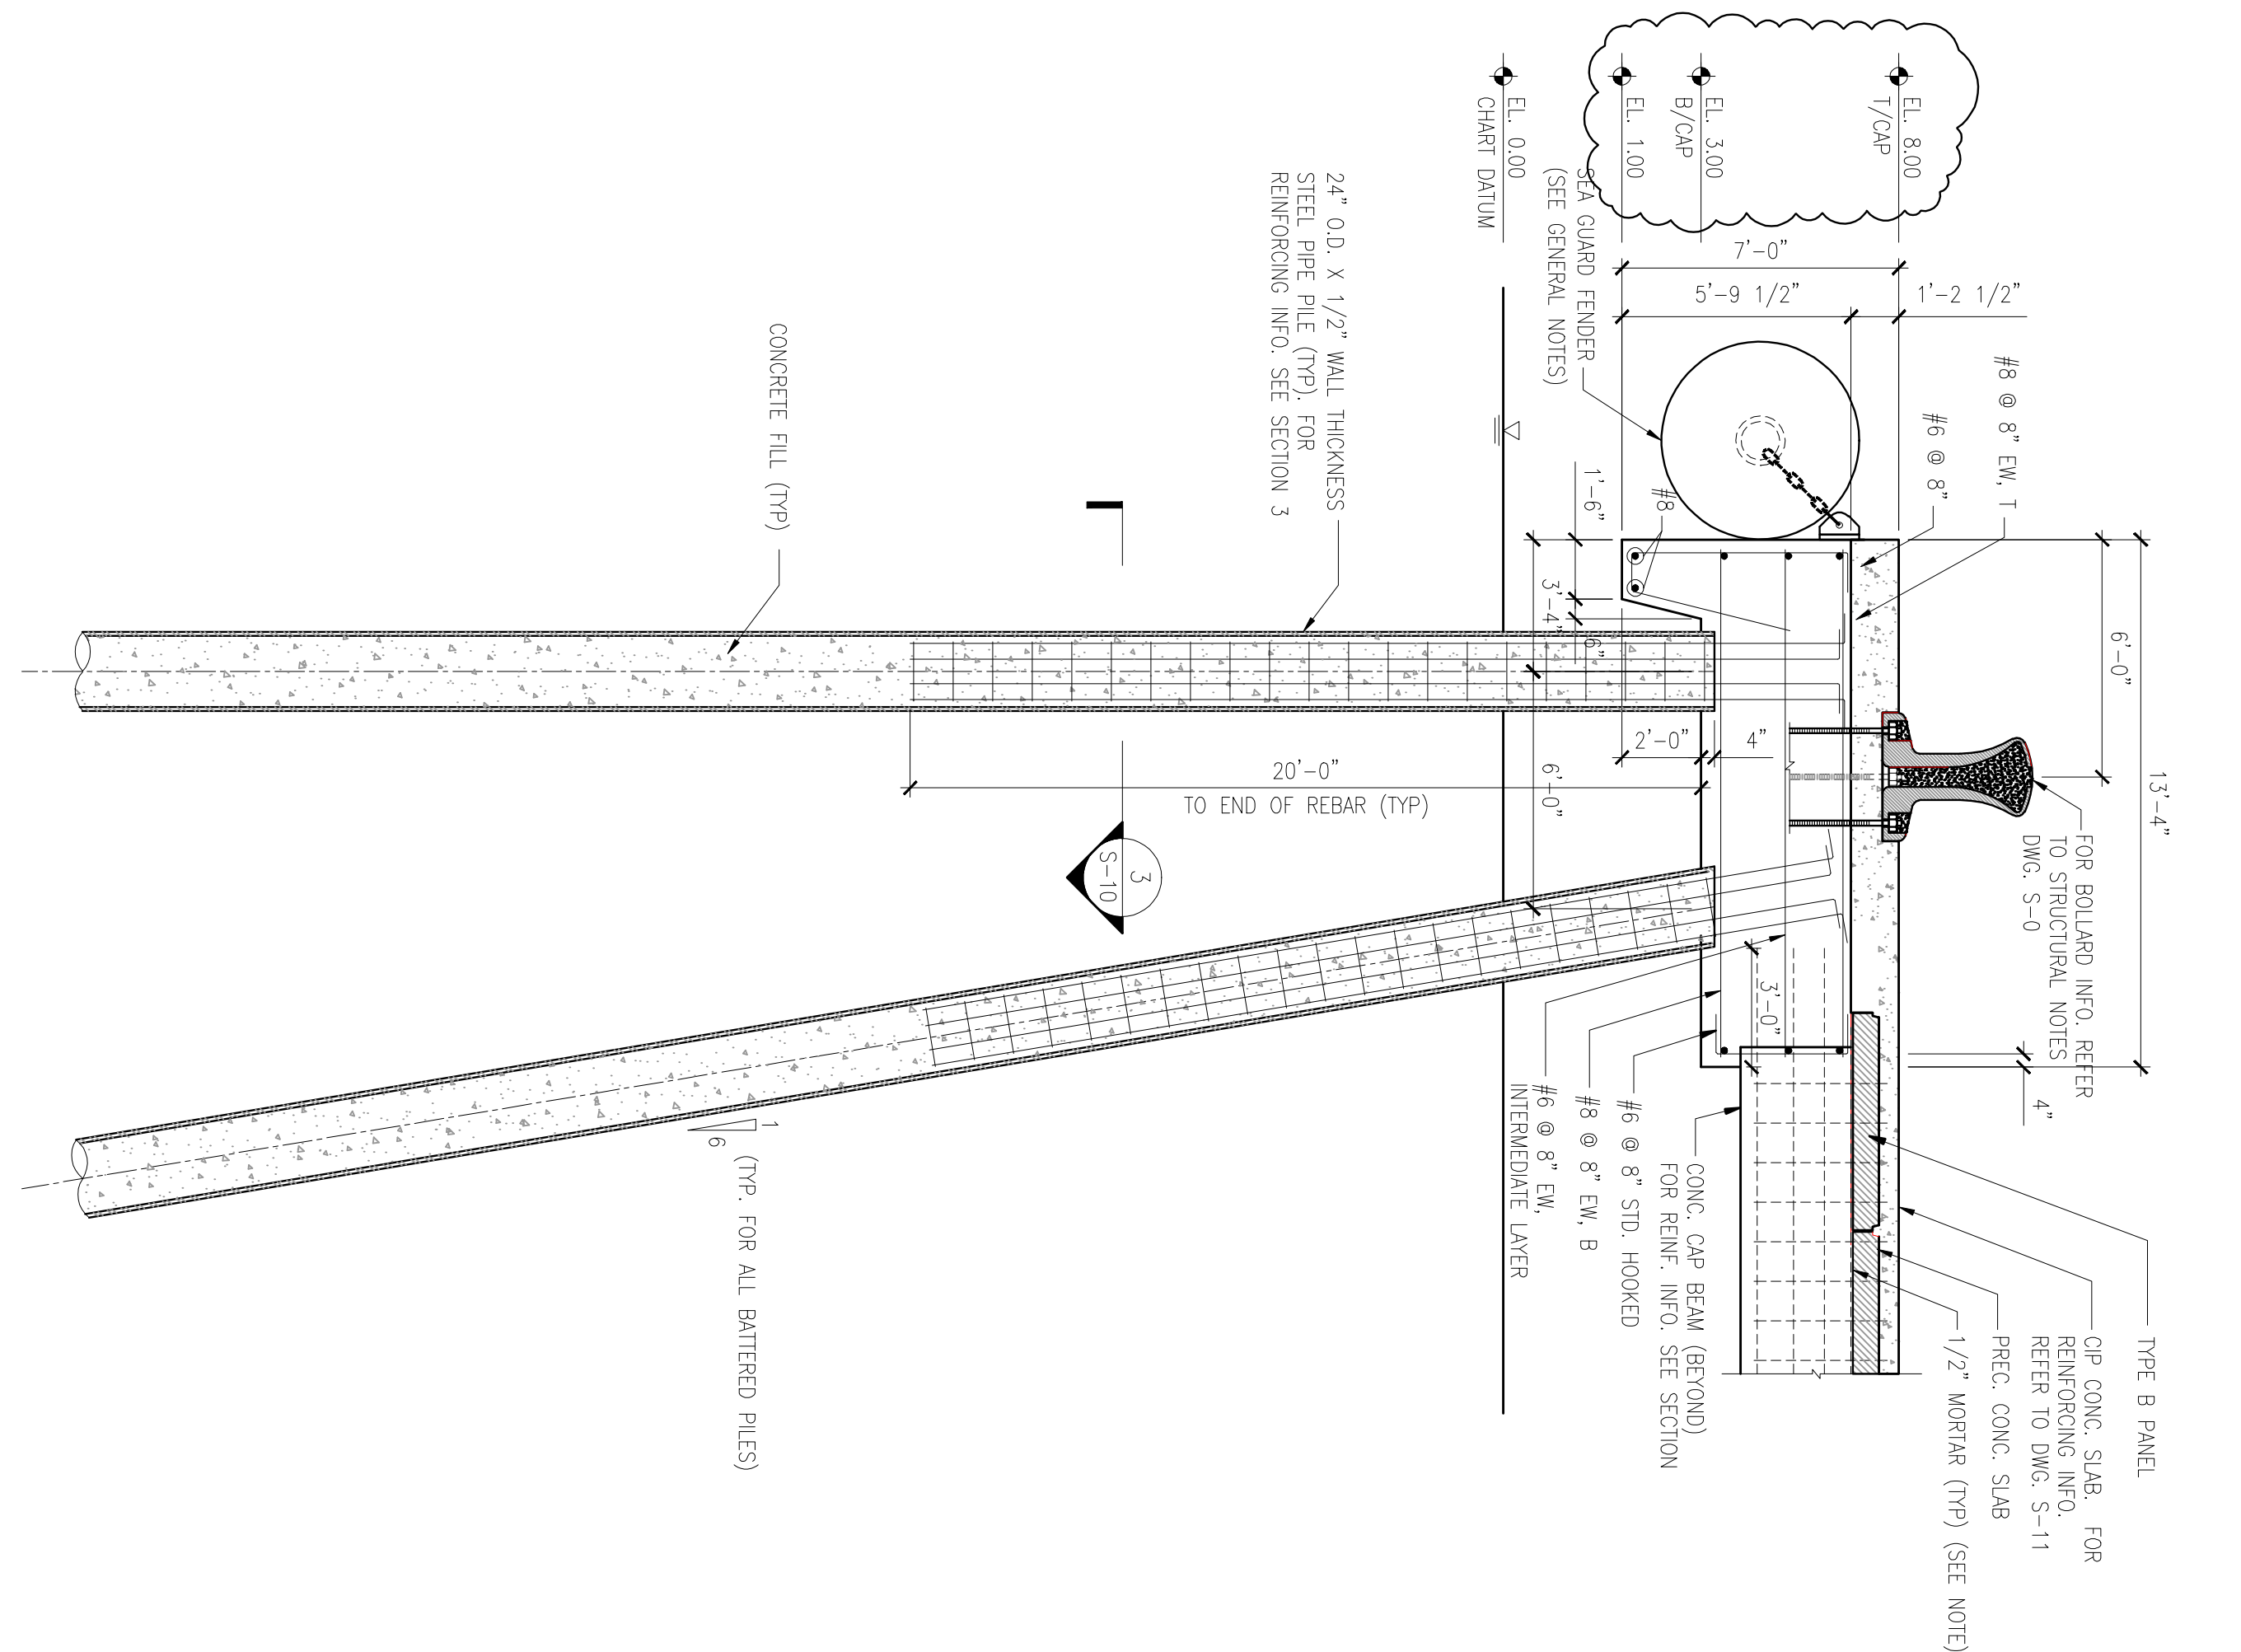


**1 DETAIL**  
S-5  
N.T.S.

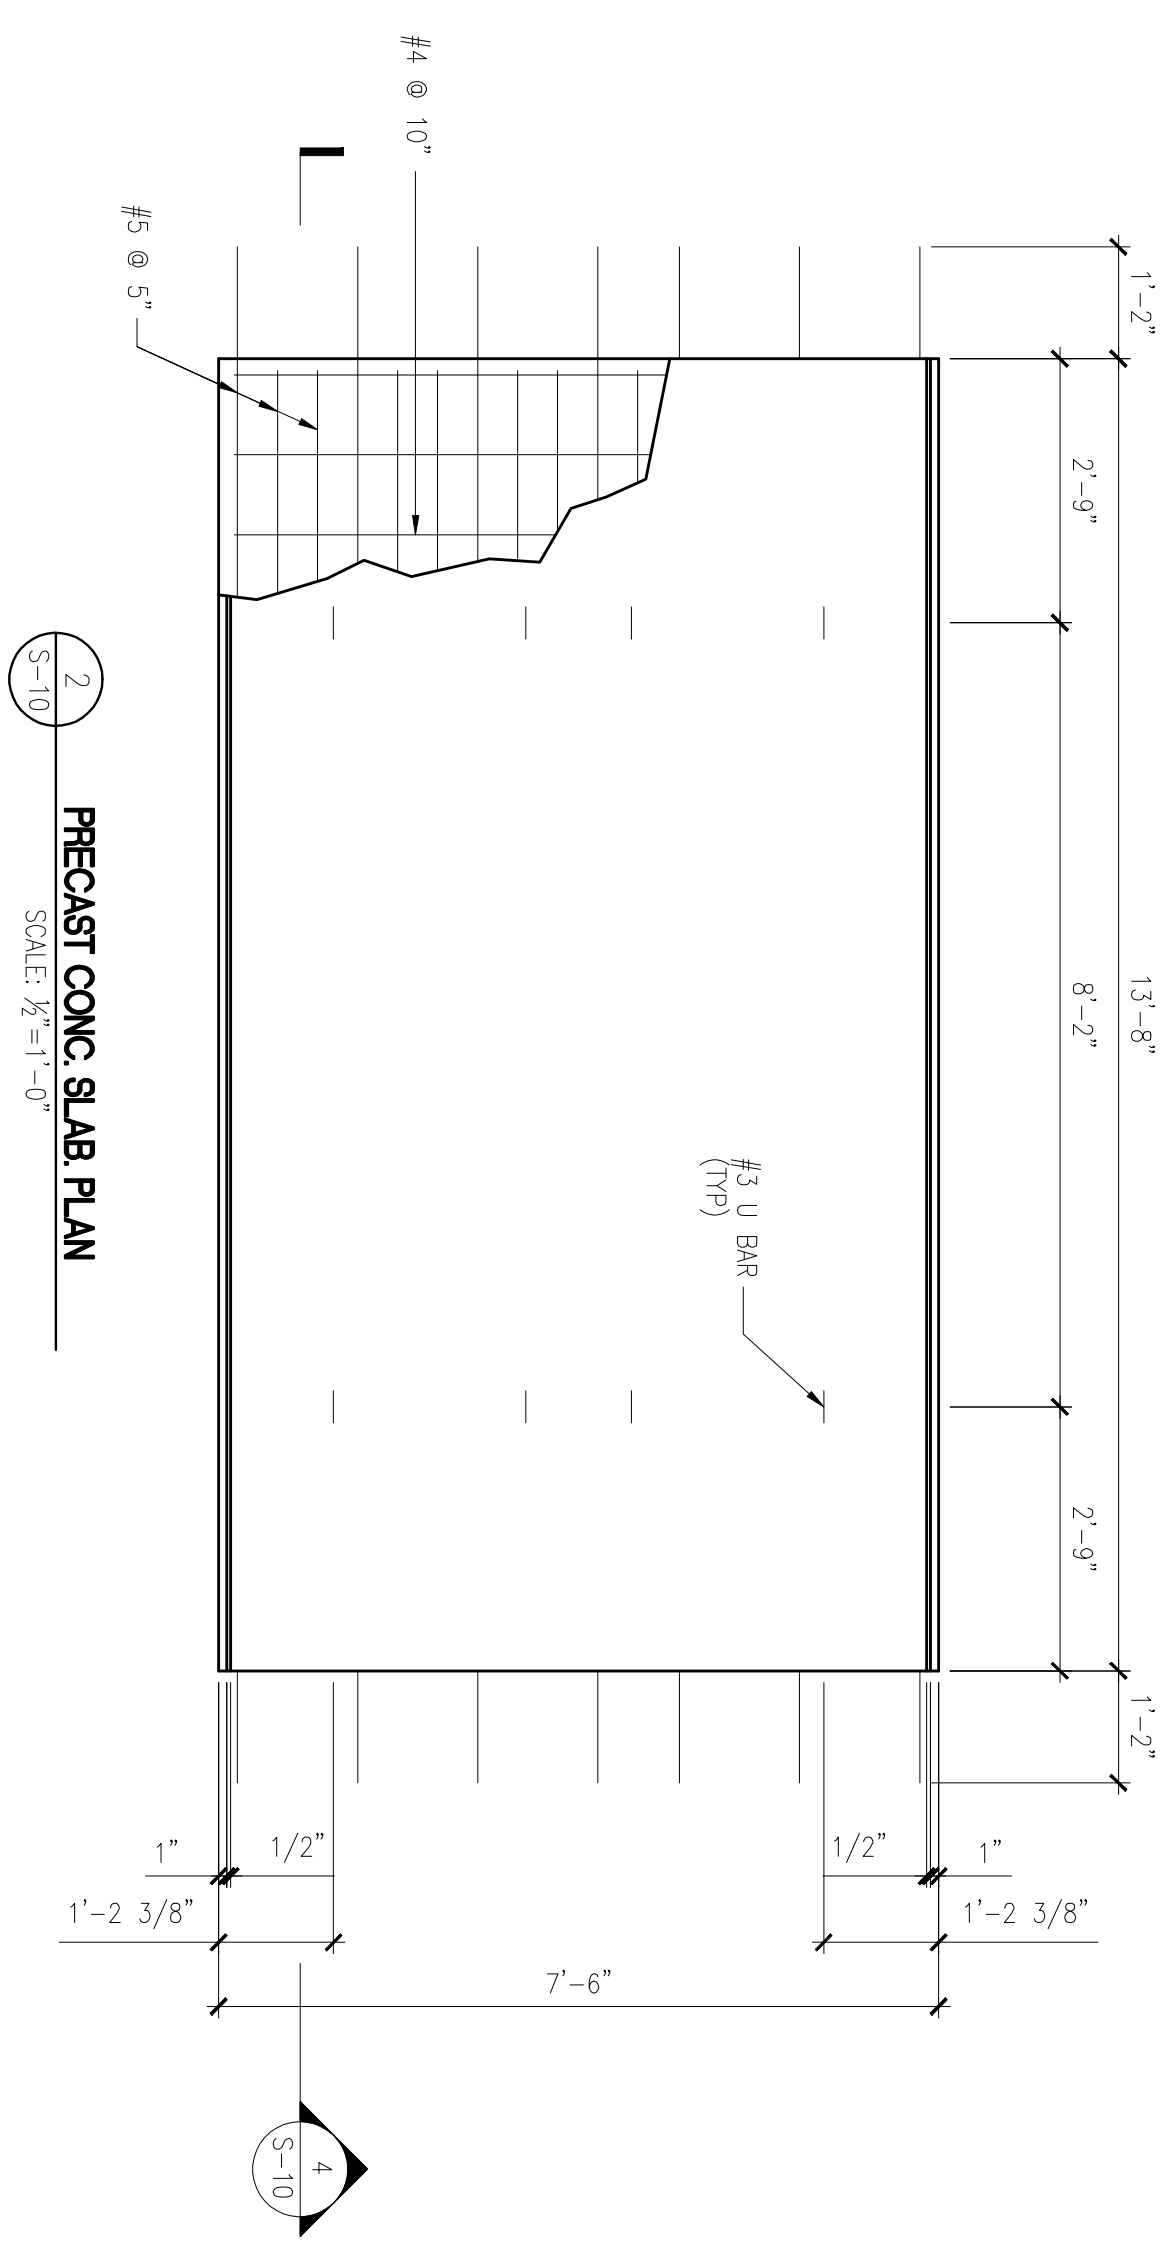


**2 PRECAST CONC. SLAB PLAN**  
S-10  
SCALE: 1/2"=1'-0"

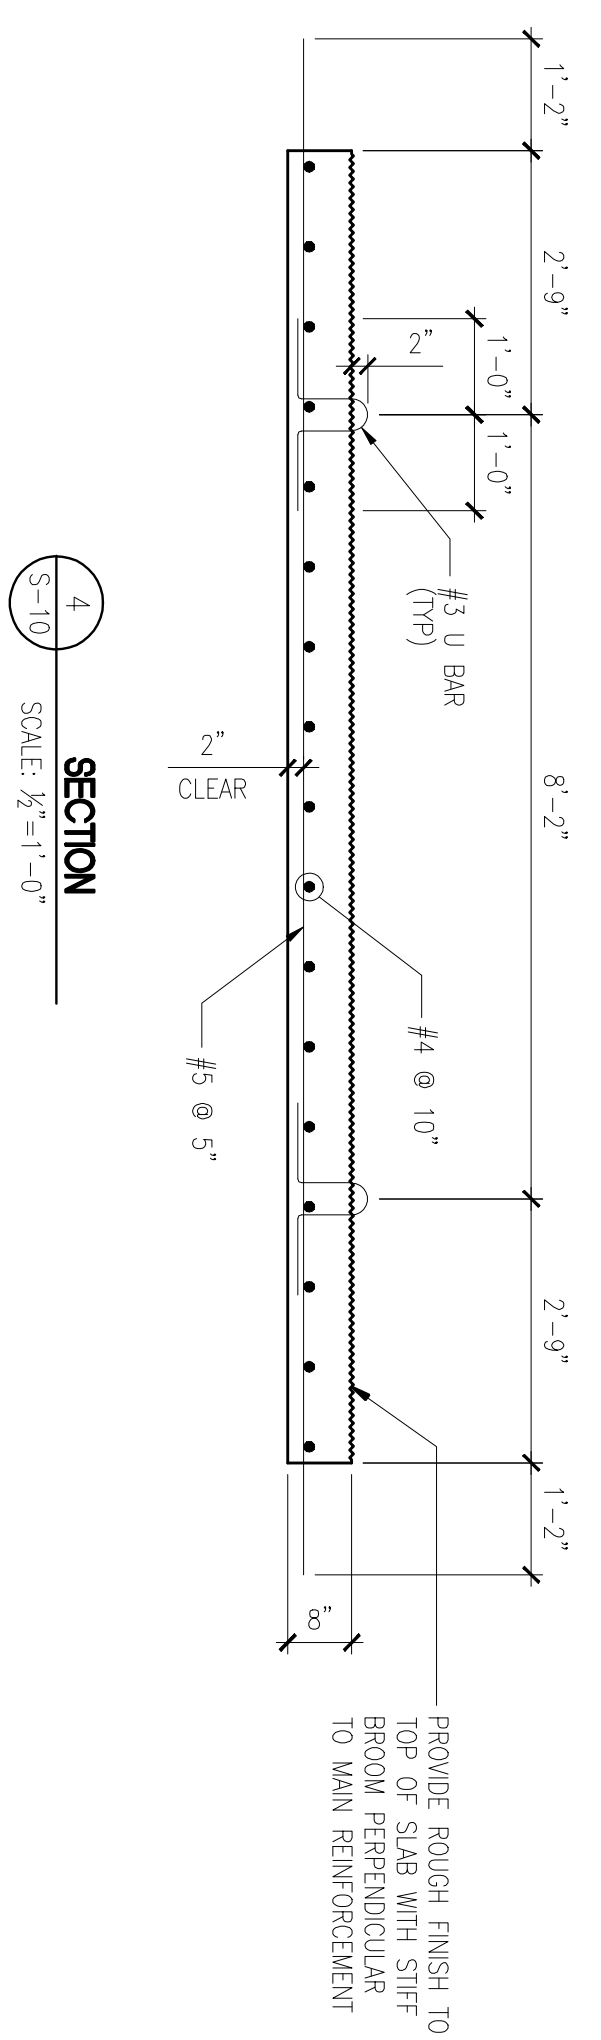


**4 SECTION**  
S-10  
SCALE: 1/2"=1'-0"

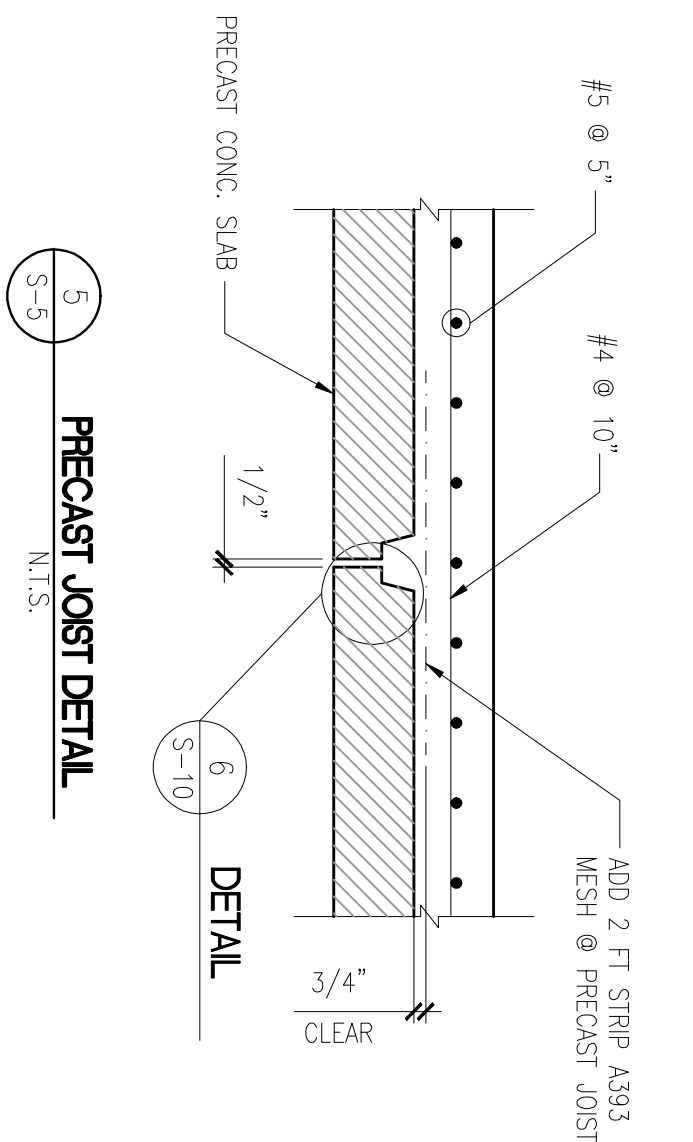

**5 PRECAST JOIST DETAIL**  
S-5  
N.T.S.

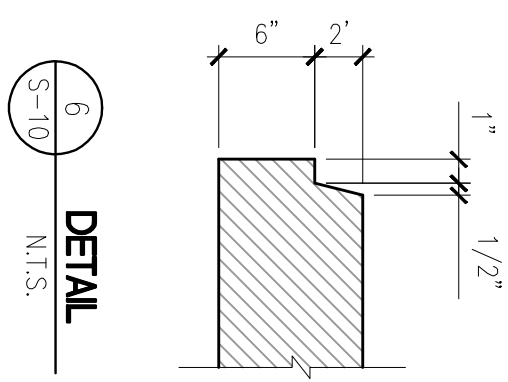

**6 DETAIL**  
S-10  
N.T.S.

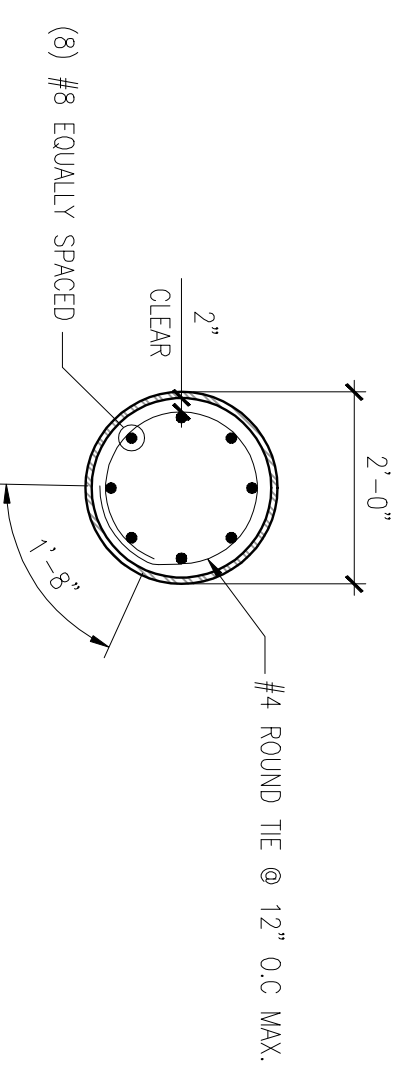

**3 PILE CROSS SECTION**  
S-10  
SCALE: 1/2"=1'-0"

**EnTech**  
LIMITED  
ENGINEERING / PLANNING CONSULTANTS  
P.O. BOX HM 2574  
HAMILTON HMKX  
BERMUDA  
TEL: (441) 282-9182  
FAX: (441) 282-9488  
EMAIL: admin@entech.bm

PROJECT	WEST END DEVELOPMENT CORPORATION
TITLE	PIER SECTIONS & DETAILS
designed by	DR scale AS SHOWN
drawn by	job no. E07017
checked by	DR drawing no.
approved by	date
CLIENT	March 07
DATE	30.AUG.07
REVISION	ADJUSTED ELEVATIONS
DATE	05.MAY.07
REVISION	REVISED PRECAST DETAILS
DATE	01.MAY.07
REVISION	ISSUED FOR BUILDING PERMIT
CONTRACTORS SHALL VERIFY ALL DIMENSIONS AND UTILITY LOCATIONS ON THE JOB SITE.	

**S-10**